


PERMIT # _____

LOCATION FALCOLN RIDGE Sec. 1
Subdivision or Tax Map Ref.)

WATER SUPPLY AND/OR SEWAGE DISPOSAL SYSTEMS AS INSTALLED

211 Falcon Ridge Road

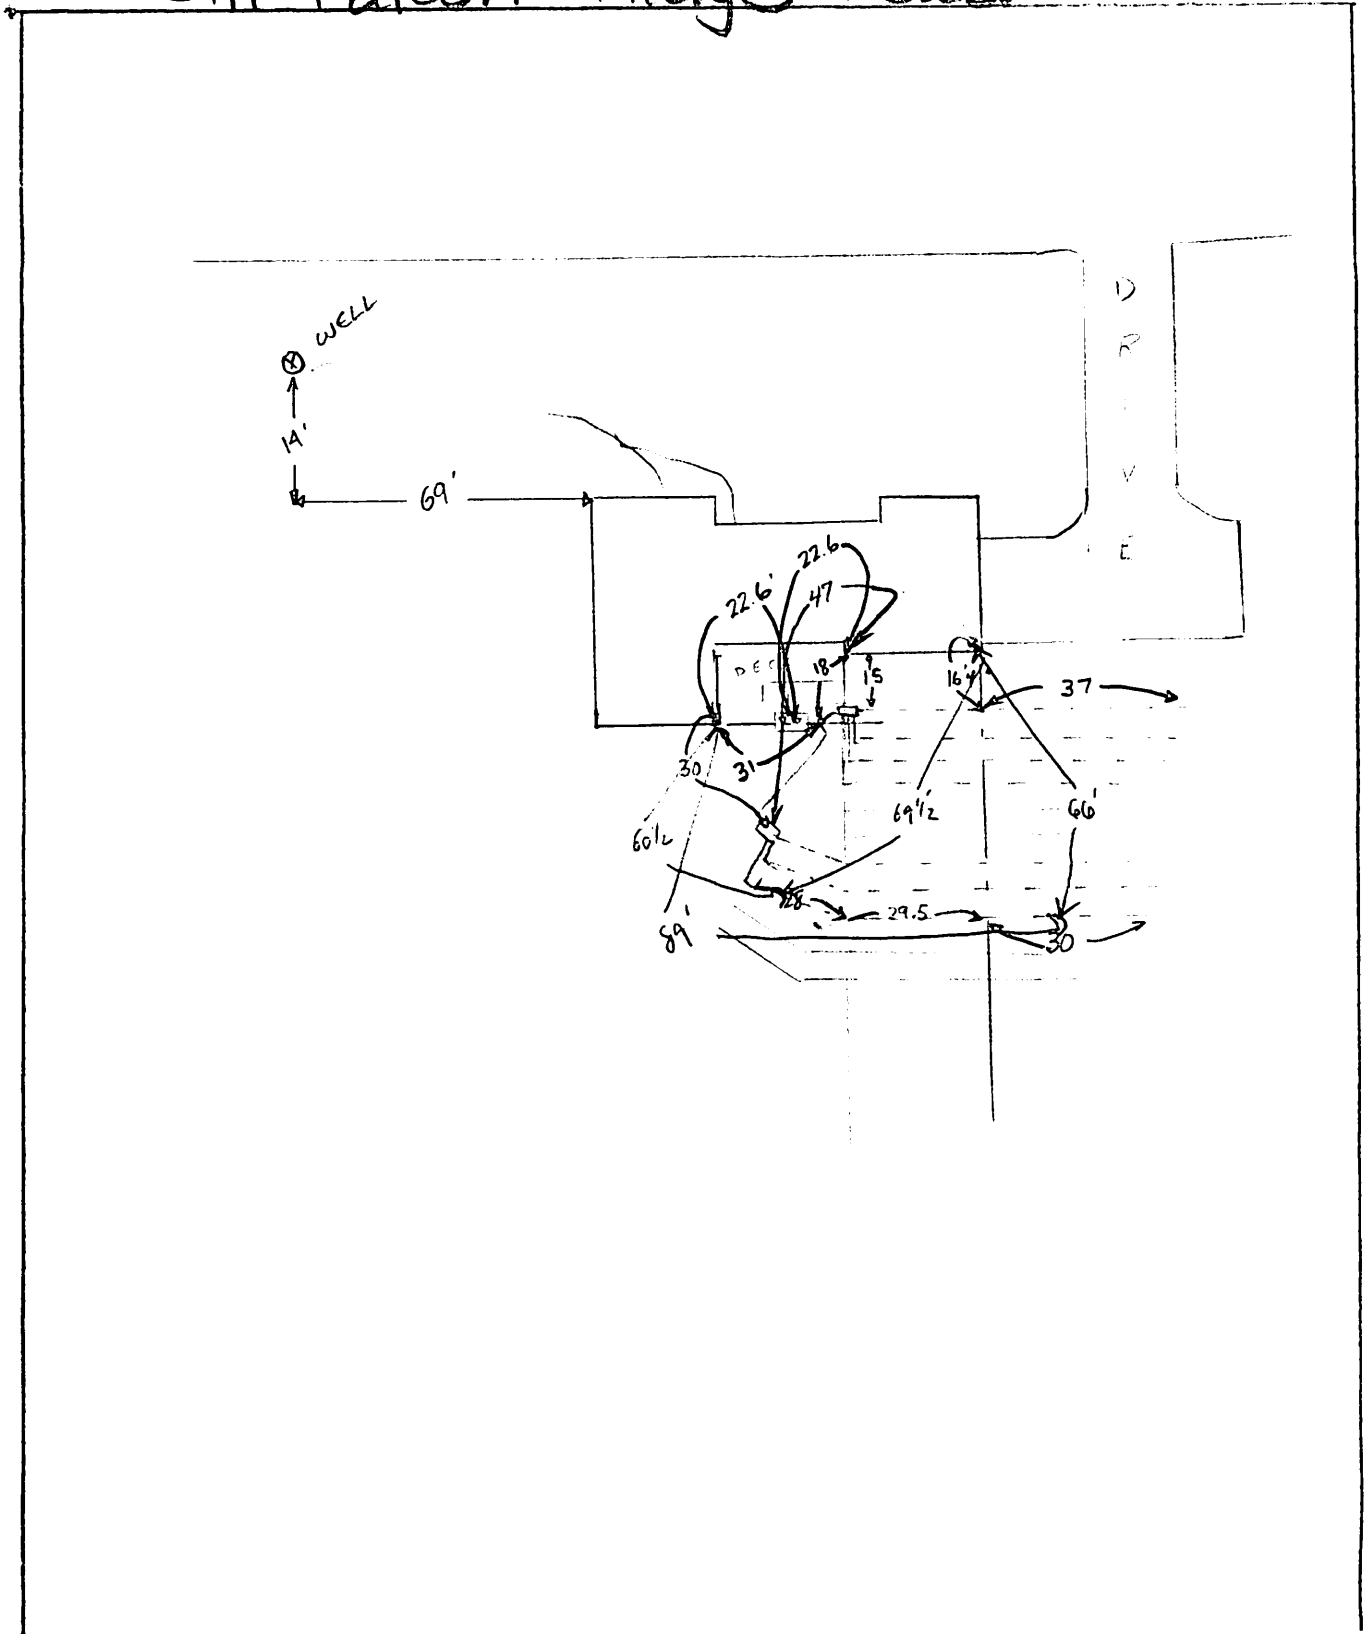

Sketch to show location of septic tank flow diversion valve distribution boxes and well.