


PERMIT # 79-655

LOCATION: LOCKMEADE TM: 12-1-007-49  
(Subdivision or Tax Map Ref.)

WATER SUPPLY AND/OR SEWAGE DISPOSAL SYSTEMS AS INSTALLED

1000 Riva Ridge Dr

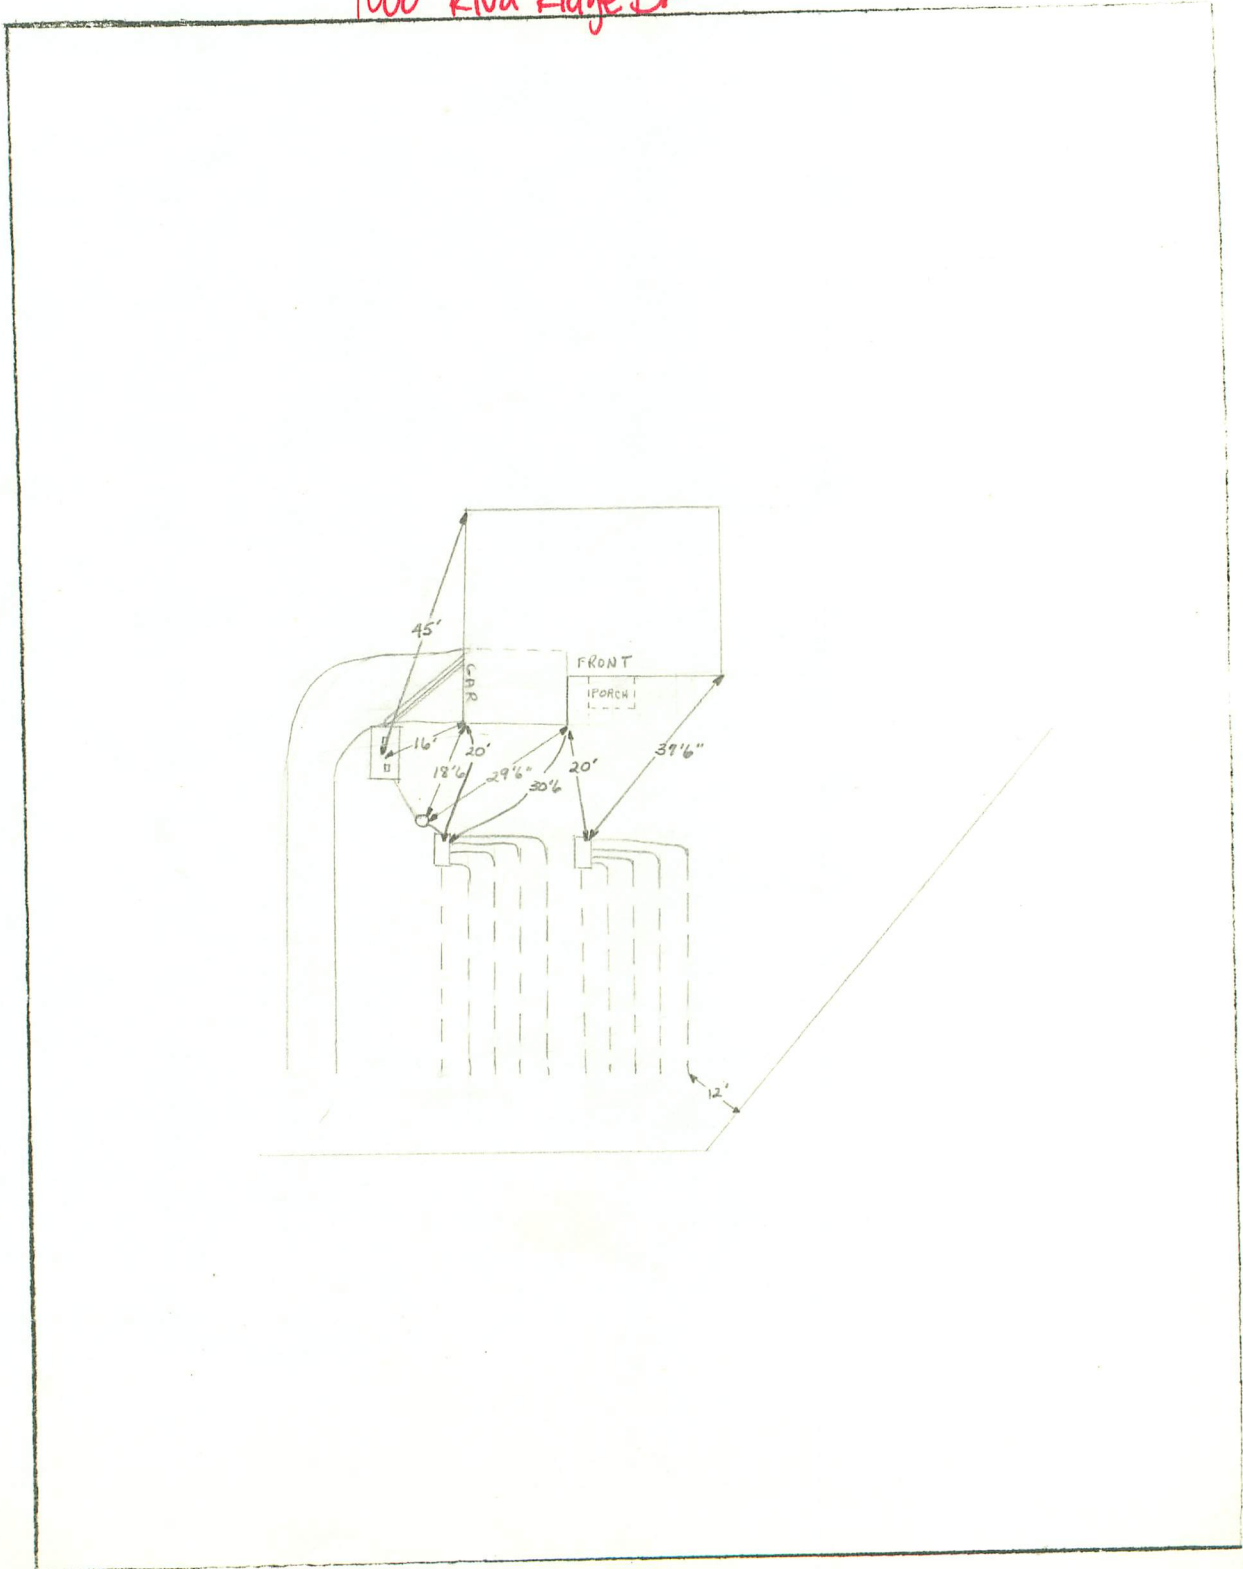

Sketch to show location of septic tank flow diversion valve distribution boxes and well.