


PERMIT # 76-155

LOCATION: 12-2-0010-155
Subdivision or Tax Map Ref.

WATER SUPPLY AND/OR SEWAGE DISPOSAL SYSTEMS AS INSTALLED

901 Cattle Lane

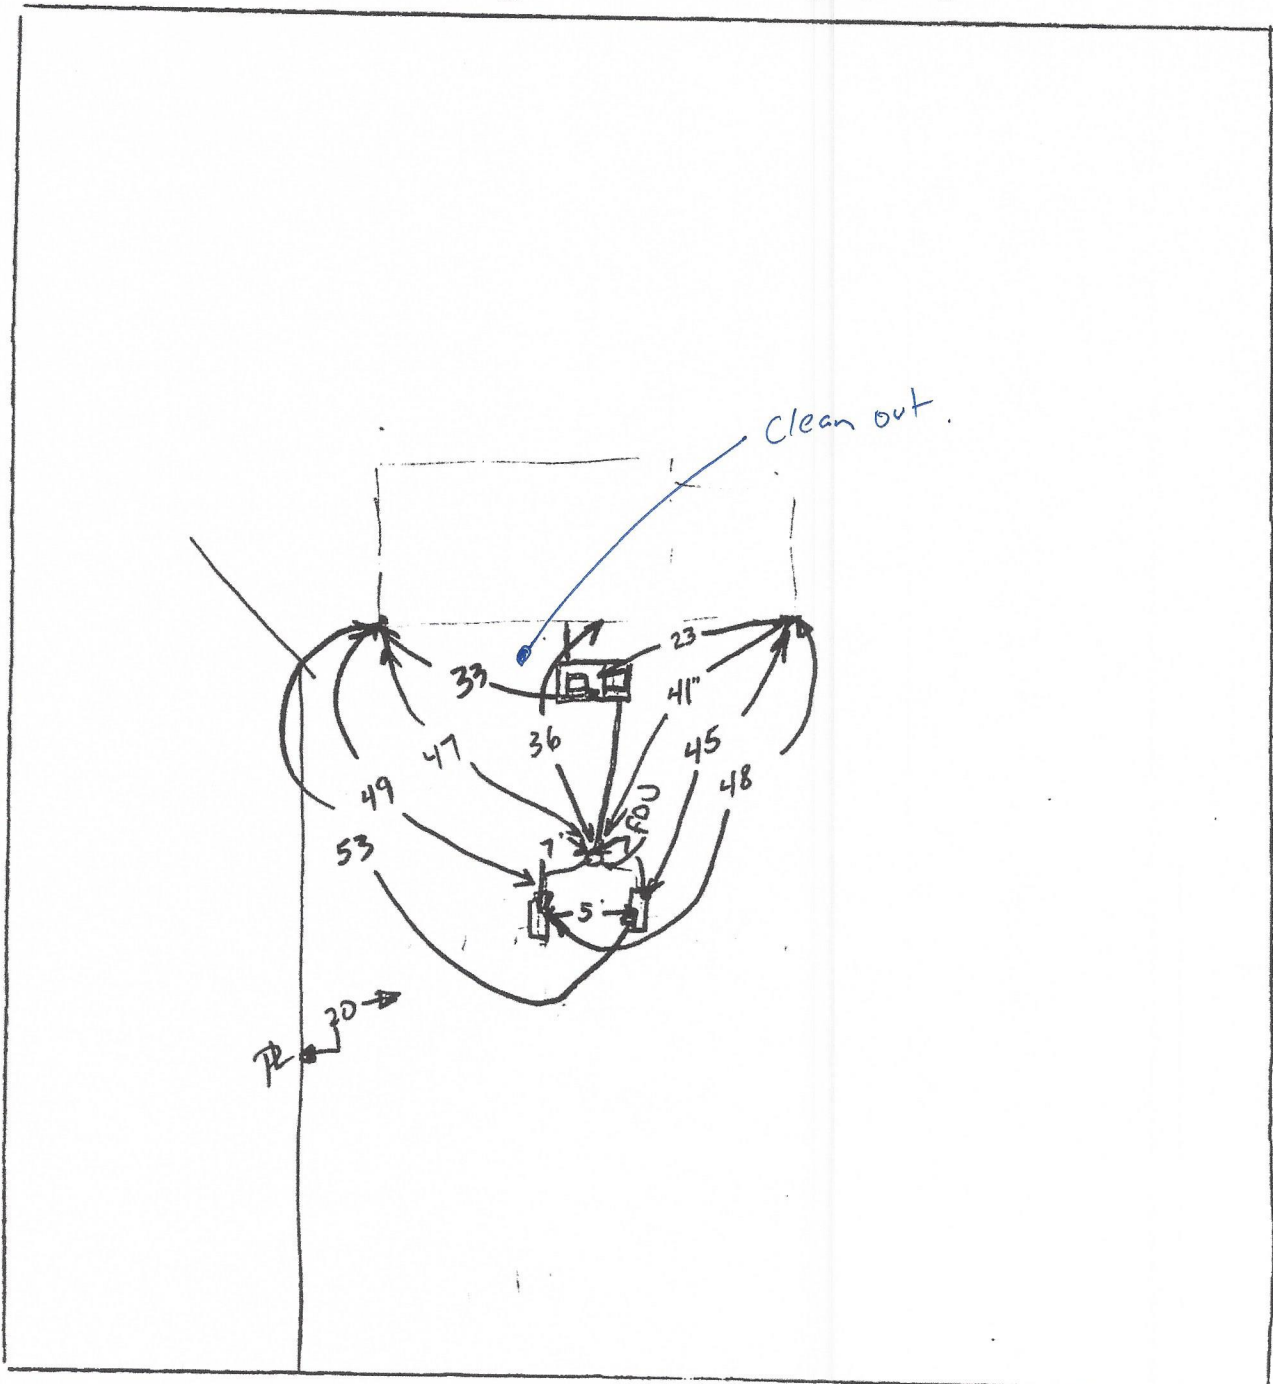

Sketch to show location of septic tank flow diversion valve distribution boxes and well.

4' in