


FAIRFAX/FALLS CHURCH HEALTH DISTRICT
FAIRFAX, VIRGINIA

PERMIT # 129-91-1013

SUB: BROOKSIDE EAST, LOT 5
LOCATION 28-3-0028-5
(Subdivision or Tax Map Ref.)

WATER SUPPLY AND/OR SEWAGE DISPOSAL SYSTEMS AS INSTALLED
AT 1769 BROOKSIDE LANE, VIENNA, VIRGINIA 22180

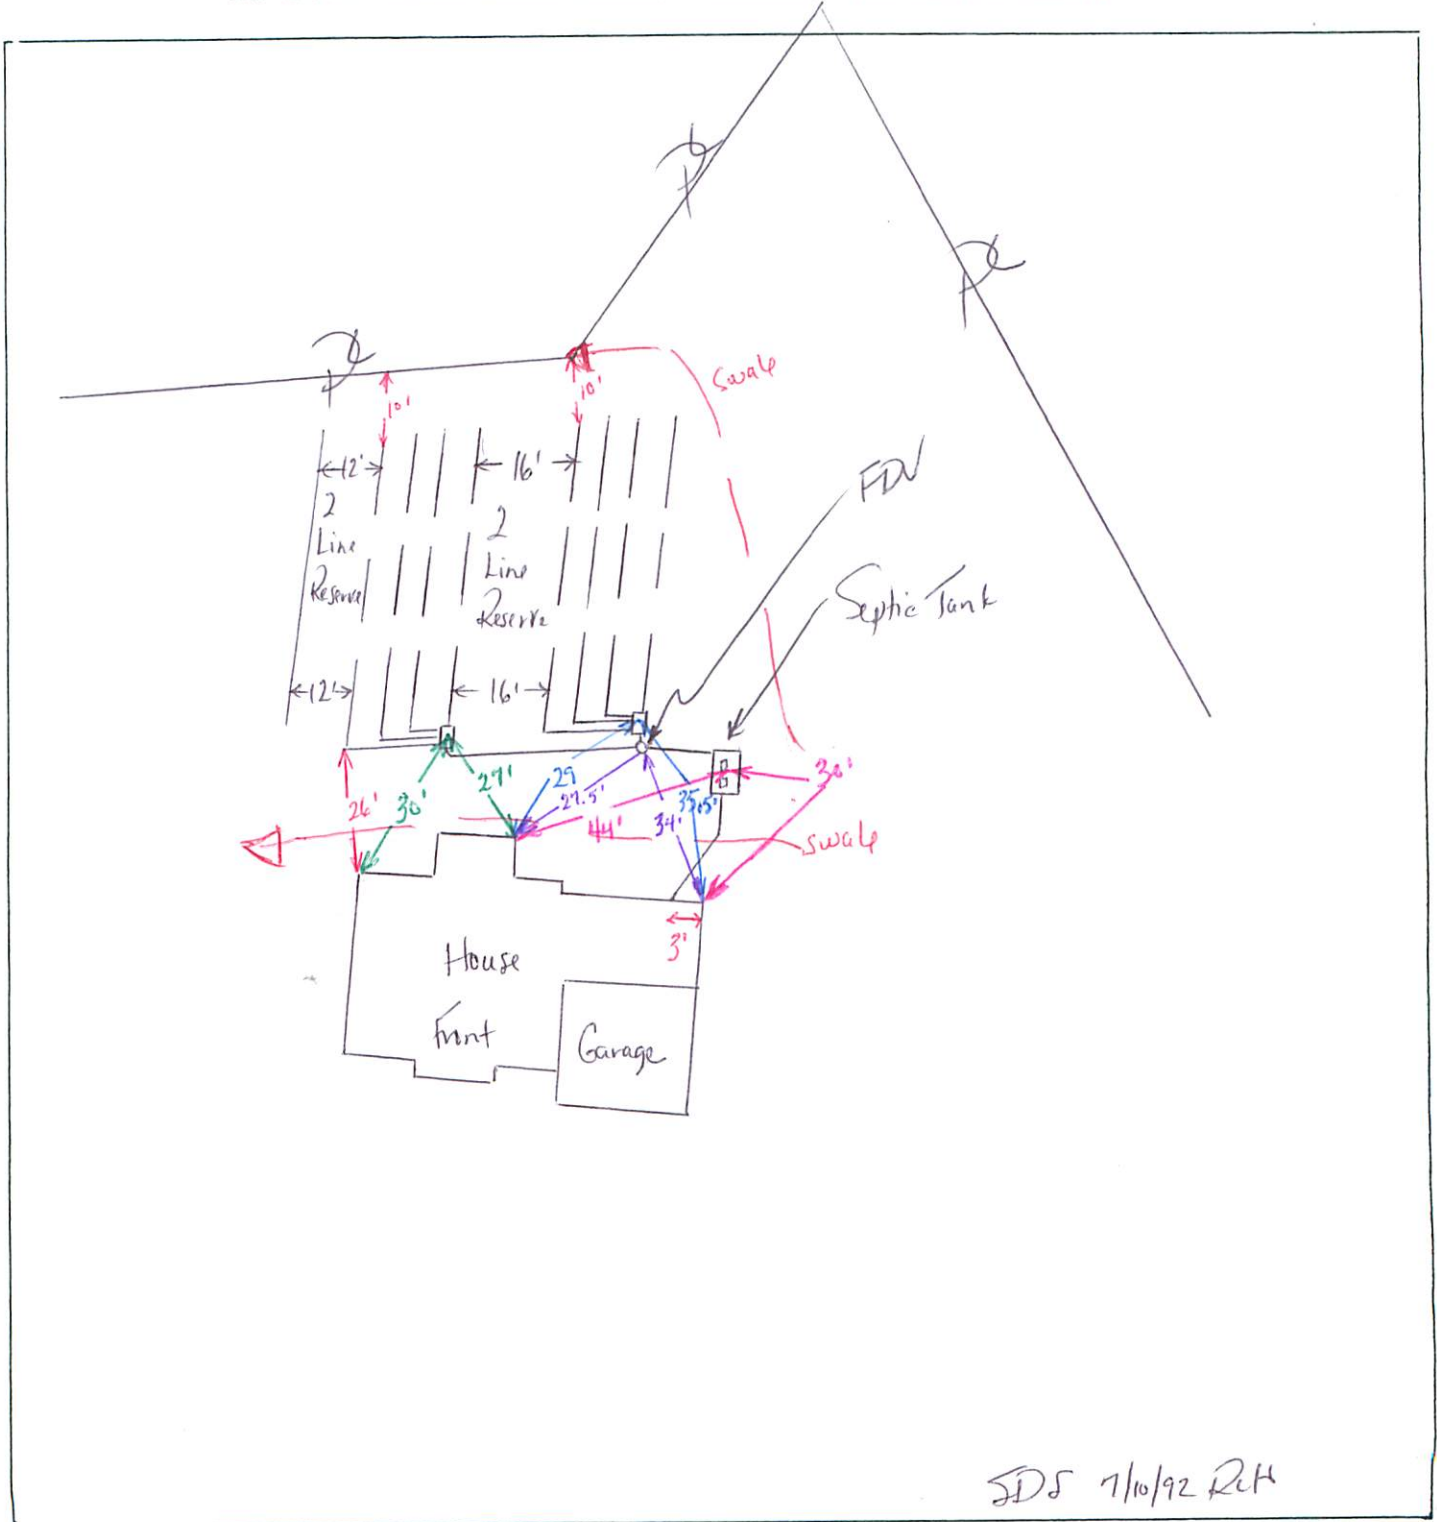

Sketch and show location of septic tank flow diversion valve distribution boxes and well.