


FAIRFAX/FALLS CHURCH HEALTH DISTRICT
FAIRFAX, VIRGINIA

PERMIT # 129-84-0016

LOCATION: TM: 7-4-001-3C
(Subdivision or Tax Map Ref.)

WATER SUPPLY AND/OR SEWAGE DISPOSAL SYSTEMS AS INSTALLED

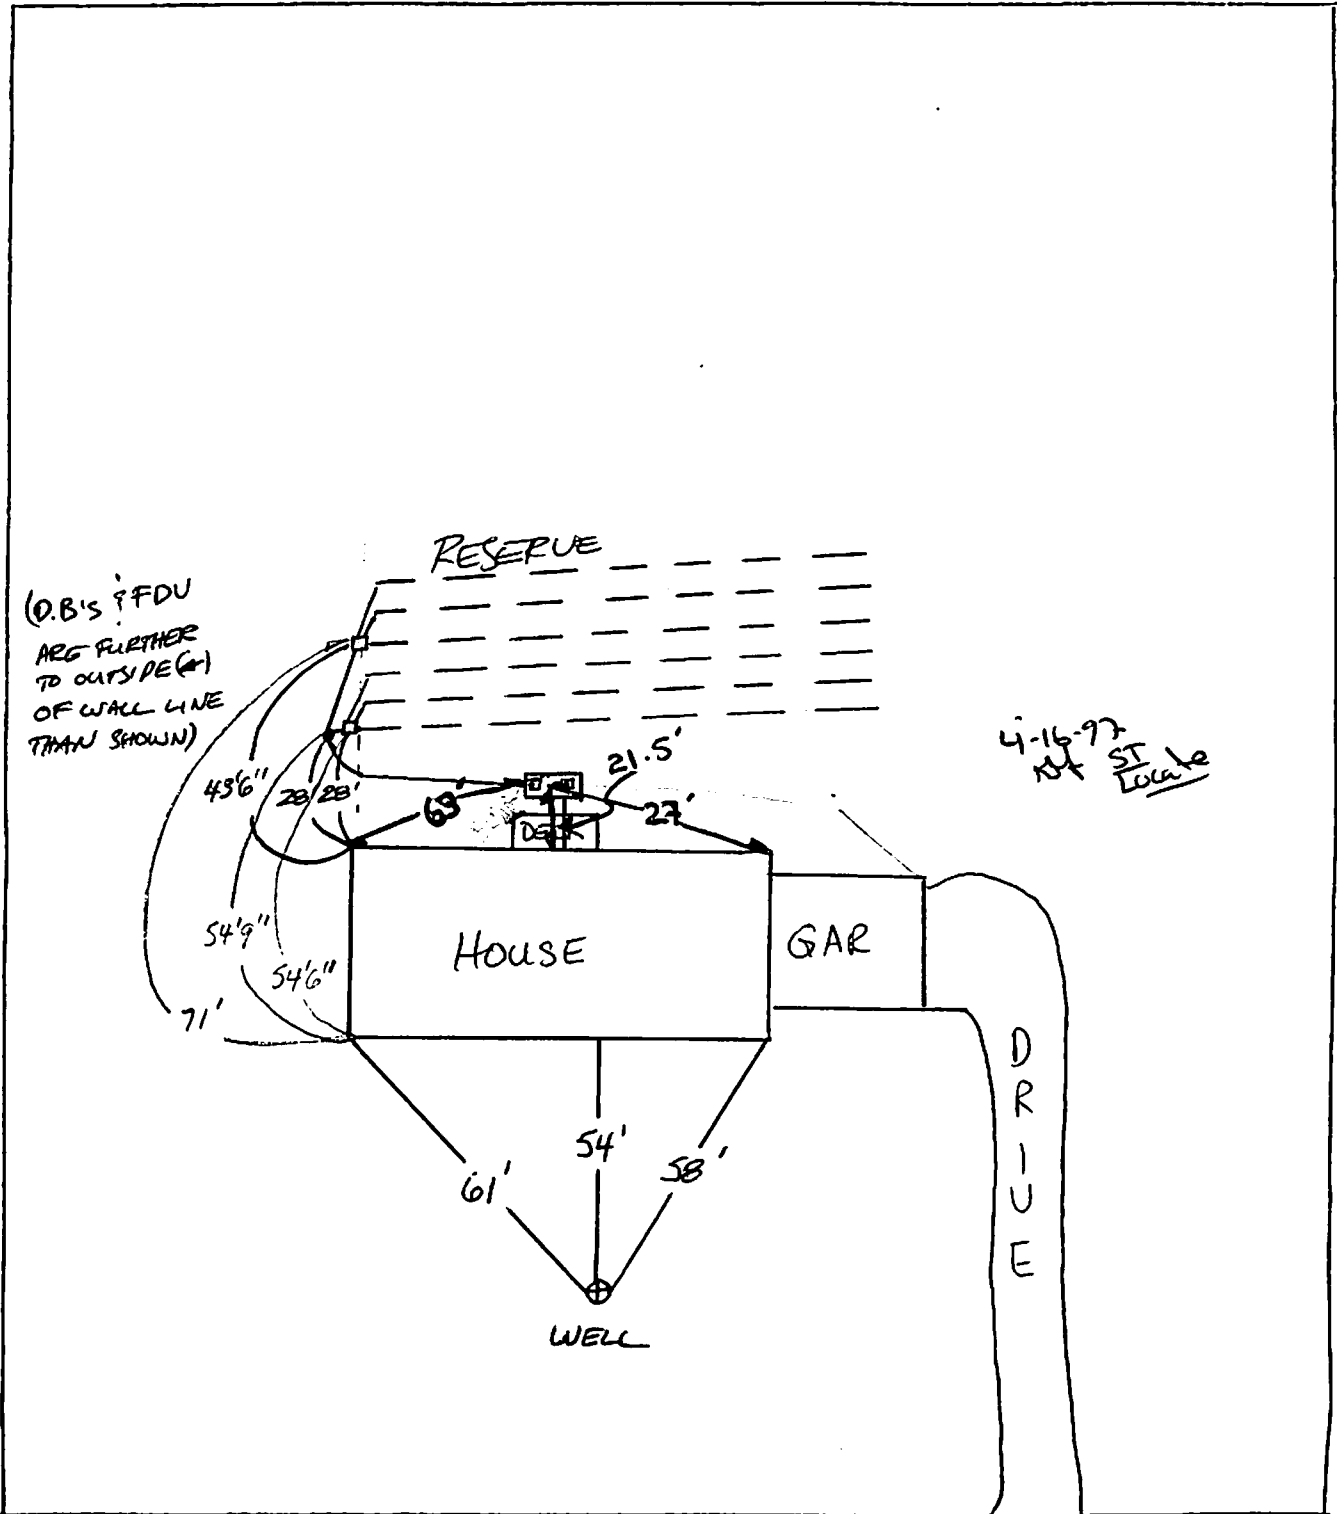

Sketch to show location of septic tank flow diversion valve distribution boxes and well.