


PERMIT # 129-87-0738

LOCATION HICKORY VALE FARM, LOT 10
(Subdivision or Tax Map Ref.)

WATER SUPPLY AND/OR SEWAGE DISPOSAL SYSTEMS AS INSTALLED

794 Stephanie Ct

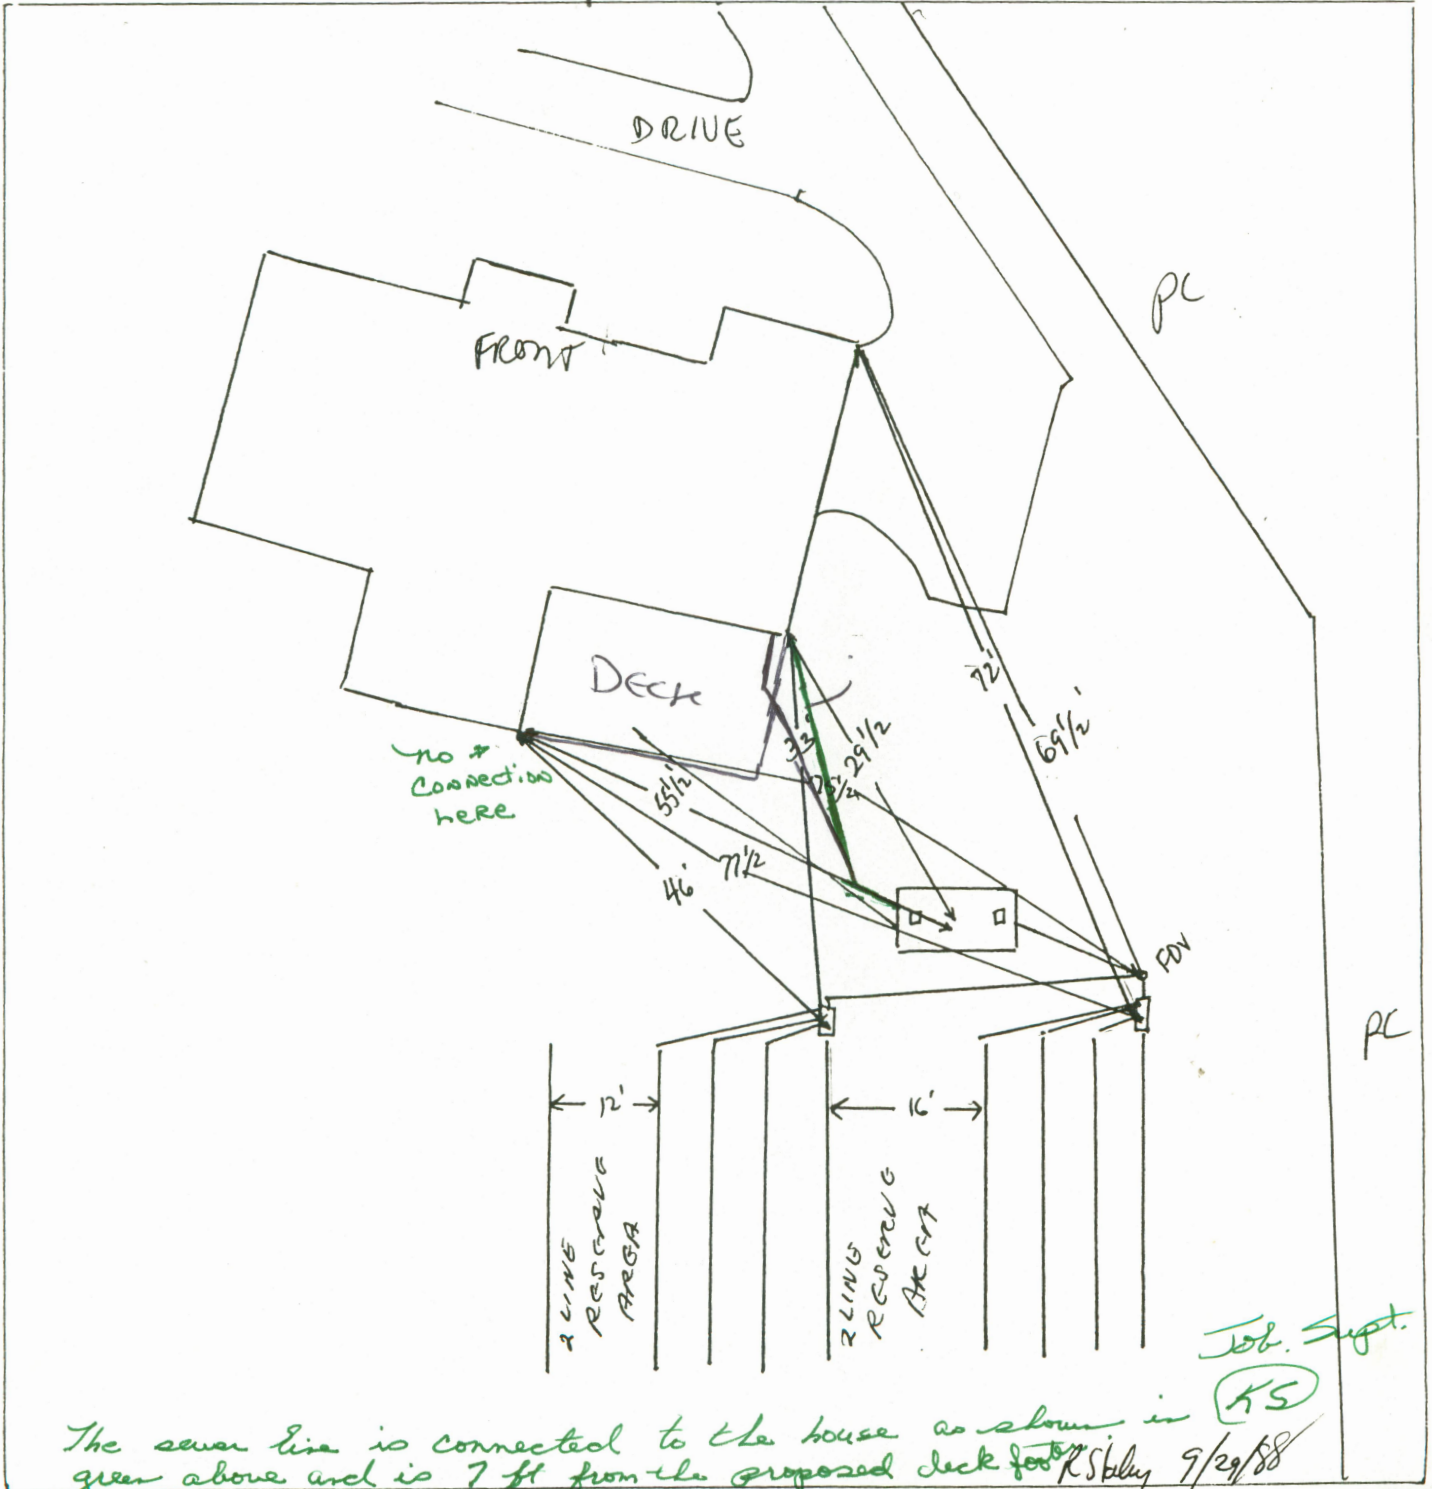

Sketch and show location of septic tank flow diversion valve distribution boxes and well.