


PERMIT # 75-416

LOCATION: 7-4-007-29
Subdivision or Tax Map Ref.

WATER SUPPLY AND/OR SEWAGE DISPOSAL SYSTEMS AS INSTALLED

707 Forest Park Rd

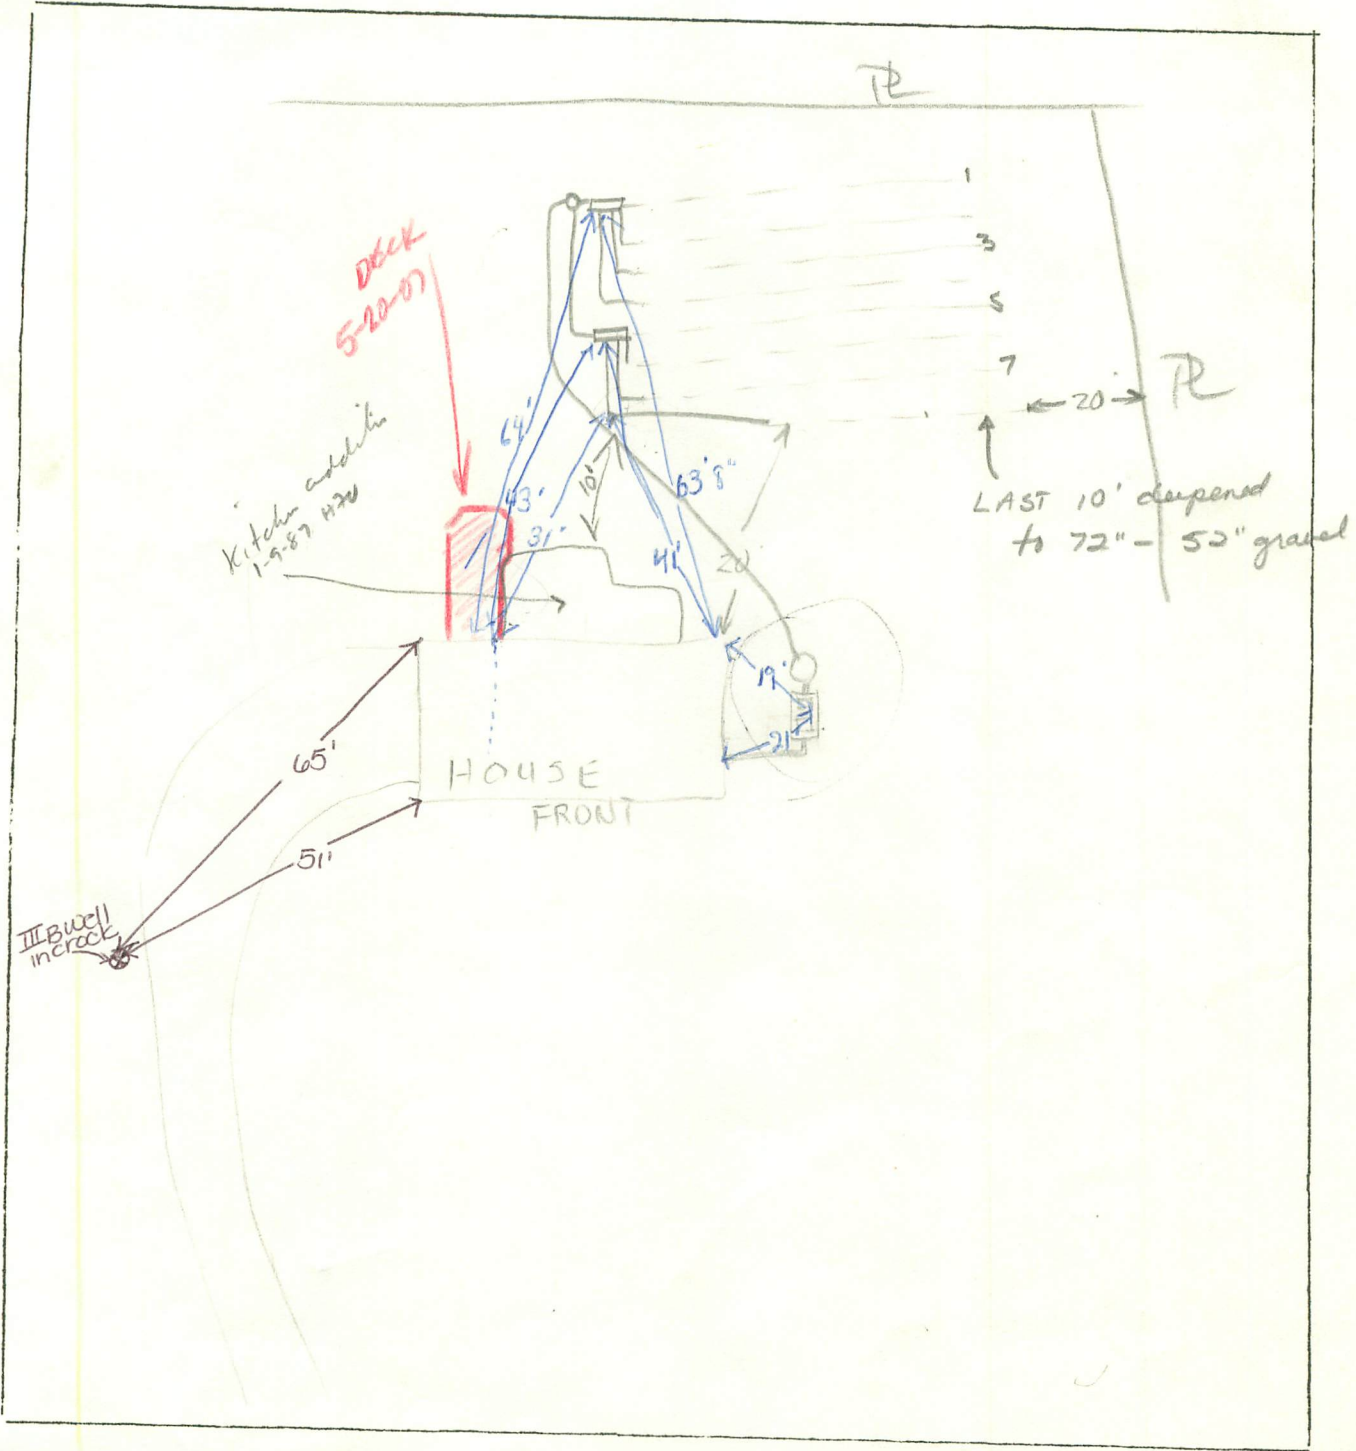

WSS as-built 9/2/05 *WJF*

Sketch to show location of septic tank flow diversion valve distribution boxes and well.