

PERMIT # 77-564


LOCATION: Frost/Dawson

7-3-001-11

Subdivision or Tax Map Ref.

WATER SUPPLY AND/OR SEWAGE DISPOSAL SYSTEMS AS INSTALLED

636 Springvale Road

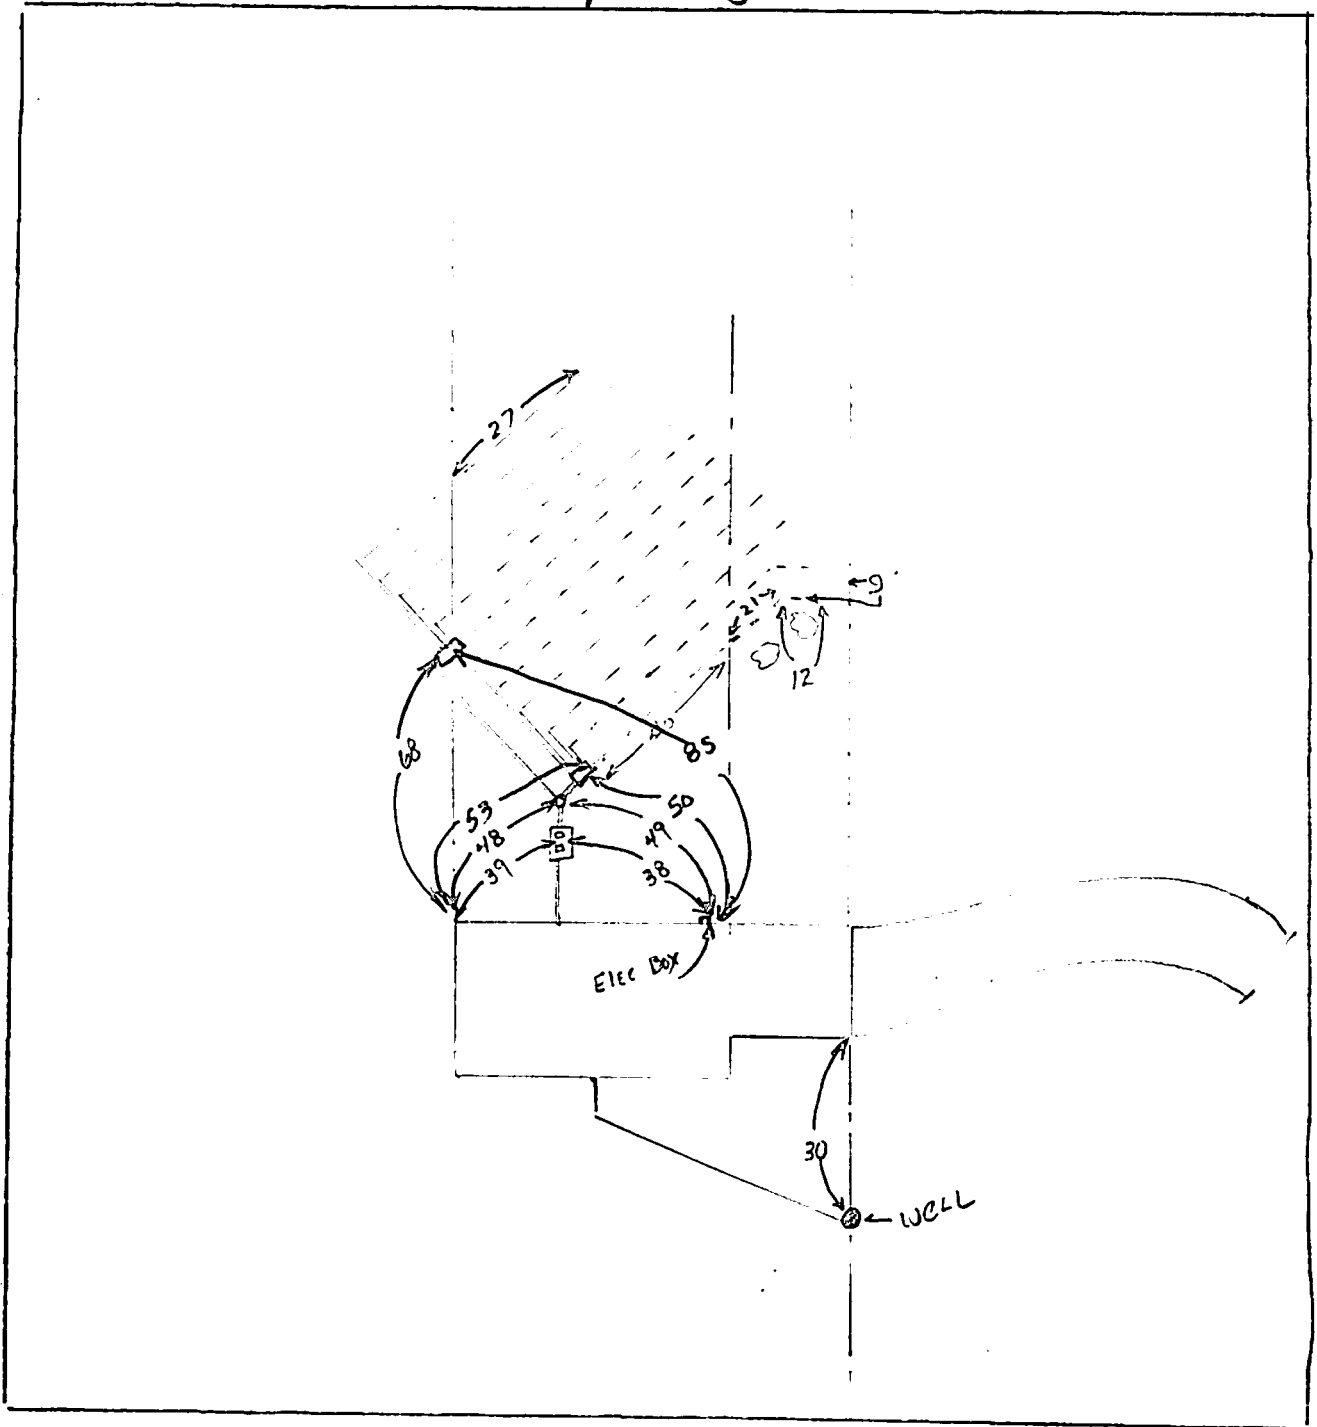

Sketch to show location of septic tank flow diversion valve distribution boxes and well.